

Alcorn Co
 A1 A7
 6-69

MISSISSIPPI
 BOARD OF WATER COMMISSIONERS
 416 North State Street
 Jackson, Mississippi 39201

WATER WELL DRILLERS LOG


ADDED

6/1/69 date well completed J. S. Miller firm name Alcorn county well located

LANDOWNER: Bartley L. G. Walnut Miss

description of formations encountered
Clay
Red sand & Red

(mailing address)
 WELL LOCATION: 32 15 5E
 sec. 2 T. 2 N. R. 2 E
5 miles NE of Walnut
 (distance) (direction) (nearest town)

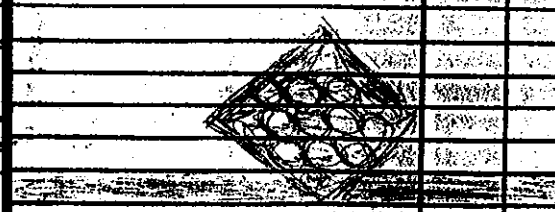

WELL PURPOSE:
 (home, irrigation, municipal, industrial)

WELL COMPLETION DATA:

- (1) diameter (inches) 4"
- (2) total depth (feet) 125
- (3) static water level (feet) 95 below top of ground
- (4) casing P 125
 (material) (depth)
4 if telescope see back.
 (size)
- (5) screen 90 105
 (length) (depth to top)
4 P
 (size) (material)
- (6) pump 3/4 60
 (HP) (yield gpm)
E
 (type power)
- (7) electric log (yes or no) _____
 (organization running log) _____
- (8) how well bottom plugged _____

DRILLERS REMARKS:

JUL 14 1969
 MISS. BD. OF WATER COMM.