

ALCORN  
B14  
5-67

MISSISSIPPI  
BOARD OF WATER COMMISSIONERS  
416 North State Street  
Jackson, Mississippi 39201

**CODED**

WATER WELL DRILLERS LOG

May 29 1967 Bonds Plumbing & Drilling Co. Alcorn  
date well completed firm name county well located

LANDOWNER: Buford Lassiter

Cornith, Miss.  
(mailing address)

WELL LOCATION:

sec. 28 T. 1 N R. 6 E  
S W  
9 miles W of Cornith  
(distance) (direction) (nearest town)


WELL PURPOSE: Home  
(home, irrigation, municipal, industrial)

WELL COMPLETION DATA:

- (1) diameter (inches) 4"
- (2) total depth (feet) 430'
- (3) static water level (feet) 130' below above top of ground.
- (4) casing BK steel, 33 (material), (depth)  
4" (size) if telescope see back.
- (5) screen 1/2" (size), (depth to top)  
1/2" (size) (material)
- (6) pump 2 H.P. 5 1/2 (HP) (yield gpm)  
Elect. (type power)
- (7) electric log no (yes or no)  
(organization running log)
- (8) how well bottom plugged OPEN

description of formations encountered	from	to
Sandy loam	0'	2'
Red #1 Clay	2'	12'
Yellow sand gravel	12'	24'
White " #2 Rock	24'	28'
Blue Clay	28'	36'
" " + shells	36'	38'
Fine gray water sand	38'	450'

**CODED**

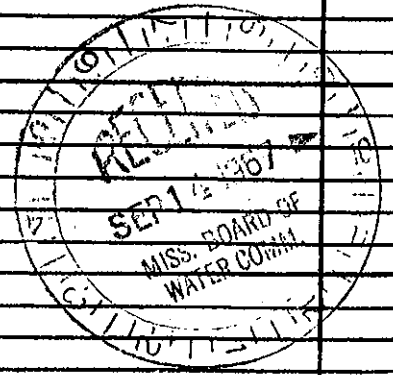

DRILLERS REMARKS: