

Alcorn  
C50  
4-67

MISSISSIPPI  
BOARD OF WATER COMMISSIONERS  
416 North State Street  
Jackson, Mississippi 39201

**CODED**

WATER WELL DRILLERS LOG

Apr. 29 1967 Bonds Plumbing & Drilling Alcorn  
date well completed firm name county well located

LANDOWNER: W. R. Stewart  
Wenasoga Road  
Cornith, Miss  
(mailing address)


WELL LOCATION:  
sec. 28 T. 1 N R. 7 E 3 1/4 SE 1/4 Section  
1 1/2 miles West Cornith City  
(distance) (direction) (nearest town)

WELL PURPOSE: home  
(home, irrigation, municipal, industrial)

- WELL COMPLETION DATA:
- (1) diameter (inches) 4"
  - (2) total depth (feet) 290'
  - (3) static water level (feet) 137' <sup>below</sup> above top of ground.
  - (4) casing bk. steel 33'  
(material) (depth)  
4" if telescope see back.  
(size)
  - (5) screen 2 (length) (depth to top)  
(size) (material)
  - (6) pump 1/2 hp (yield gpm)  
1/2 hp (type power)
  - (7) electric log no (yes or no)  
(organization running log)
  - (8) how well bottom plugged open

description of formations encountered	from	to
Red Sandy clay	0'	4'
Red sand	4'	10'
Yellow Limestone	10'	30'
Blue Clay	30'	100'
" " <u>to horizon</u>		
hitting <u>lime shells</u>	100'	215'
<u>sandy blue</u>	215'	225'
<u>water sand</u>	225'	290'

**CODED**

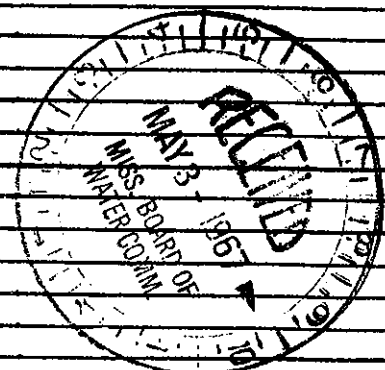

DRILLERS REMARKS: