

ALCORN
C51
5-67

MISSISSIPPI
BOARD OF WATER COMMISSIONERS
416 North State Street
Jackson, Mississippi 39201

CODED

WATER WELL DRILLERS LOG

May 9 1962 Beds Plumbing & Drilling Alcorn
date well completed firm name county well located

LANDOWNER: Jerman Dawson

Cornith, Miss.
(mailing address)

WELL LOCATION:
sec. 24 T. 1 N. R. 7 E.
1 1/2 miles N of Cornith
(distance) (direction) (nearest town)


WELL PURPOSE: Home
(home, irrigation, municipal, industrial)

WELL COMPLETION DATA:

- (1) diameter (inches) 4"
- (2) total depth (feet) 190'
- (3) static water level (feet) 70 below above top of ground.
- (4) casing Bk steel, 21'
(material) (depth)
4" if telescope see back.
(size)
- (5) screen None (depth to top)
(size) (material)
- (6) pump 7 5
(HP) (yield gpm)
Elect.
(type power)
- (7) electric log no
(yes or no)
(organization running log)
- (8) how well bottom plugged Open

description of formations encountered	from	to
<u>Red Clay</u>	<u>0'</u>	<u>12'</u>
<u>Red sand</u>	<u>12'</u>	<u>19'</u>
<u>Blue Clay</u>	<u>19'</u>	<u>30'</u>
<u>" " / shells</u>	<u>30'</u>	<u>137'</u>
<u>Rock</u>	<u>137'</u>	<u>137'</u>
<u>Coarse sand</u>	<u>138'</u>	<u>146'</u>
<u>Water bearing sand</u>	<u>146'</u>	<u>190'</u>

CODED

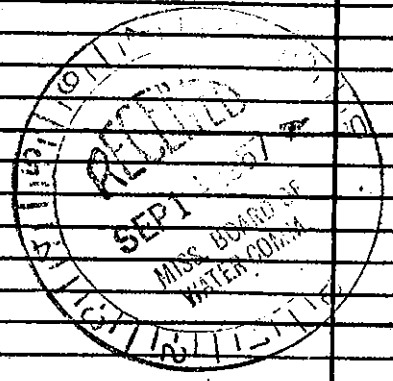

DRILLERS REMARKS: