

Alcorn

C 59

8-67

MISSISSIPPI BOARD OF WATER COMMISSIONER

CODED

WATER WELL DRILLERS LOG

Date: 8-4, 1967, Driller: Con. F. Fair County Alcorn
(When well drilled) (Name) (Where well is located)

(1) Owner of Land:	Description & Color of Materials Sand, Clay, Red Clay, Shell, etc.	Thick- ness Feet	Depth Feet
<u>John Patterson</u> (Name) <u>Rt 3 Brimch, Miss</u> (Address)	<u>Red Clay</u> <u>Blue Clay</u>	<u>27 1/2</u> <u>192 1/2</u>	<u>200</u>
(2) Location: <u>1/4</u> , <u>1/4</u> , Sec. <u>34 T. 15 R. 7 E</u> <u>1</u> miles <u>N. W</u> , of <u>Brimch</u> (distance) (direction) (Nearest Town)			
(3) Topography: _____ (Hilly) (Flat) (Level)			
(4) Purpose of Well: _____ (Domestic Irrigation Municipal, Industrial, Other)			

CODED

Information upon completion of well:

(1) Diameter 4" inches.

(2) Total Depth 200 feet.

(3) Water Level _____ feet below top of ground.

(4) Cased to 27 1/2, Size 4"

(5) Screen: Size _____, Length _____

(6) Were any formations sealed against pollution?
_____ yes, _____ no.

If YES depth of formation _____

Why _____

Drillers Remarks: _____


Yield in gpm: _____

Size pump: 7 1/2 HP Pump

Type power: _____

JUN 20 1968

MISS. BD. OF
WATER COMM.

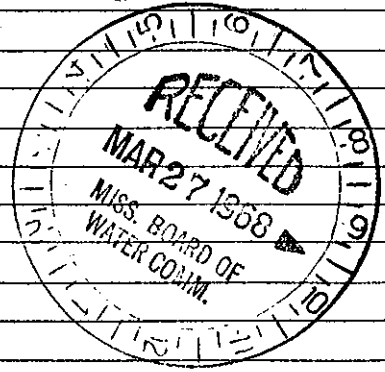

Mail this copy to Board of Water Commissioners 429 Miss. St. Jackson, Miss.