

ALCORN

MISSISSIPPI BOARD OF WATER COMMISSIONERS

D 44

7-65 WATER WELL DRILLERS LOG

CODED

Date: July, 1965, Driller: Joe Jobe County Alcorn

(1) Owner of Land: Corinth-Council RR <small>(Name)</small>	Description & Color of Materials Sand, Clay, Red Clay, Shell, etc.	Thick- ness Feet	Depth Feet
Corinth, Miss. <small>(Address)</small>	Red Clay	10	10
	Blue Clay	40	50
	Coffee Sand	21	71
(2) Location: $\frac{1}{4}$, $\frac{1}{4}$, Sec. T R			
$\frac{1}{2}$ miles North East of Corinth <small>(distance) (direction) (Nearest Town)</small>			
on Kendrick Rd. Hilly <small>(Hilly) (Flat) (Level)</small>			
(4) Purpose of Well: Domestic <small>(Domestic Irrigation Municipal, Industrial, Other)</small>			

Information upon completion of well:


- (1) Diameter 8 inches.
- (2) Total Depth 71 feet.
- (3) Water Level 3+ feet below top of ground.
- (4) Cased to 51 ft, Size 4"
- (5) Screen: Size 4", Length 20ft
Gravel Packed
- (6) Were any formations sealed against pollution?
yes, no.

If YES depth of formation _____

Why _____

Drillers Remarks: _____

CODED

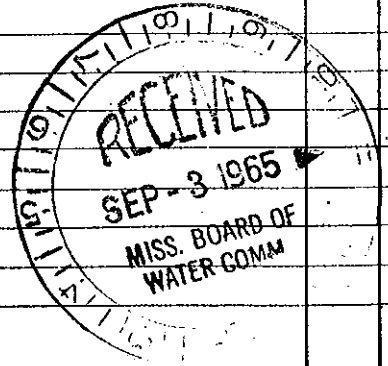

(Use Back Side)

Well No.

Mail this copy to Board of Water Commissioners 429 Miss. St. Jackson, Miss