

ALCORN

MISSISSIPPI BOARD OF WATER COMMISSIONERS

D 45

8-19-65

WATER WELL DRILLERS LOG

CODED

Date: Aug. 19, 1965, Driller: Joe Jobe County Alcorn

(1) Owner of Land: <u>Junior Smith</u> (Name) <u>Crown, Miss.</u> (Address)	Description & Color of Materials Sand, Clay, Red Clay, Shell, etc.	Thick- ness Feet	Depth Feet
	<u>Yellow Sand</u>	<u>70</u>	<u>70</u>
	<u>Blue Clay</u>	<u>10</u>	<u>80</u>
	<u>Copper Sand</u>	<u>36</u>	<u>116</u>
(2) Location: <u>1/4</u> , <u>1/4</u> , Sec. <u>T</u> <u>R</u> , <u>3</u> miles <u>NE</u> of <u>Crown</u> , (distance) (direction) (Nearest Town)			
(3) Topography: <u>Hilly</u> (Hilly) (Flat) (Level)			
(4) Purpose of Well: <u>Domestic</u> (Domestic Irrigation Municipal, Industrial, Other)			

Information upon completion of well:

(1) Diameter 8 inches.

(2) Total Depth 116 feet.

(3) Water Level 50 feet below top of ground.

(4) Cased to 96 ft, Size 4"

(5) Screen: Size 4", Length 20ft
Gravel Packed


(6) Were any formations sealed against pollution?
_____ yes, no.

If YES depth of formation _____

Why _____

Drillers Remarks: _____

CODED

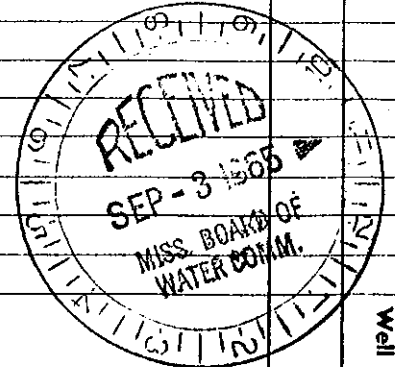

(Use Back Side)

Well No.

Mail this copy to Board of Water Commissioners 429 Miss. St. Jackson, Miss