

Alcorn
D47
8-68

MISSISSIPPI
BOARD OF WATER COMMISSIONERS
416 North State Street
Jackson, Mississippi 39201

CODED

WATER WELL DRILLERS LOG

8-15 1968 Faires well supply Alcorn
date well completed firm name county well located

LANDOWNER: Hudie Bairdellus
Kendrick Rd
Comith, Miss
(mailing address)


description of formations encountered	from	to
<u>Red clay & sand</u>	<u>0</u>	<u>61</u>

WELL LOCATION:
sec 30 T 1 N R 9 E
S W
1/2 miles N of Kendrick
(distance) (direction) (nearest town)

WELL PURPOSE:
(home) irrigation, municipal, industrial

- WELL COMPLETION DATA:
- (1) diameter (inches) 4
 - (2) total depth (feet) 61
 - (3) static water level (feet) _____ below above top of ground.
 - (4) casing 01c (material) (depth) _____
(size) if telescope see back.
 - (5) screen 5' (length) (depth to top) _____
5' (size) 01c (material)
 - (6) pump 1/2 (HP) 4 (yield gpm)
Elc (type power)
 - (7) electric log _____ (yes or no)
(organization running log)
 - (8) how well bottom plugged _____

CODED

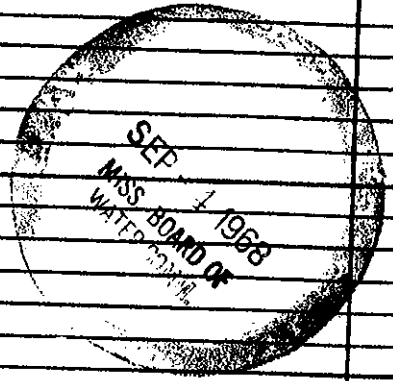

DRILLERS REMARKS: