

Alcorn

D 48
11-67

MISSISSIPPI BOARD OF WATER COMMISSIONERS

WATER WELL DRILLERS LOG

CODED


Date: 11-15, 1967, Driller: Carl F. Fairis County Alcorn
(When well drilled) (Name) (Where well is located)

(1) Owner of Land:	Description & Color of Materials Sand, Clay, Red Clay, Shell, etc.	Thick- ness Feet	Depth Feet
<u>Bud Rufmann</u> (Name) <u>Rt 2, Cornuth</u> (Address)	<u>Sand & Red clay</u>	<u>60</u>	
(2) Location: <u>1/4, 1/4, Sec. 30 P R 9E</u> <u>9 mi from Cornuth</u> <u>7/8 mi. N.E.</u> In miles (distance) of <u>Kindred</u> , (direction) (Nearest Town)			
(3) Topography: _____ (Hilly) (Flat) (Level)			
(4) Purpose of Well: _____ (Domestic Irrigation Municipal, Industrial, Other)			
Information upon completion of well:			
(1) Diameter <u>4"</u> inches.			
(2) Total Depth <u>60</u> feet.			
(3) Water Level _____ feet below top of ground.			
(4) Cased to <u>55</u> , Size <u>4"</u>			
(5) Screen: Size <u>fine</u> , Length <u>5'</u>			
(6) Were any formations sealed against pollution? <input checked="" type="checkbox"/> yes, _____ no.			
If YES depth of formation <u>30'</u>			
Why _____			
Drillers Remarks: _____			
Yield in gpm: _____			
Size pump: <u>No Pump</u>			
Type power: _____			

CODED

NOV 20 1968

MISS. BD. OF
WATER COMM.

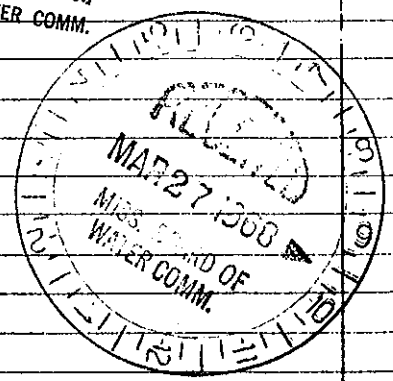

Retain this copy for your office files.