

BOARD OF WATER COMMISSIONERS

ALCORN
F 36

WATER WELL DRILLERS LOG

Date: 2-62, 19 , Driller: Bonds P. D. Co County Franklin
(Name)

(1) Owner of Land: W. J. Bagel
(Name)
Kassuth, Miss
(Address)

(2) Location: 1/4, 1/4, Sec. T. R.
1/2 miles NSW of Kassuth
(distance) (direction) (Nearest Town)

(3) Topography: Hilly
(Hilly) (Flat) (Level)

(4) Purpose of Well: Domestic
(Domestic Irrigation
Municipal, Industrial, Other)

Description & Color of Materials Sand, Clay, Red Clay, Shell, etc.	Thick- ness Feet	Depth Feet
<u>Clay Sand jointed</u>		
<u>Clay</u>	<u>30</u>	
<u>Blue</u>	<u>250</u>	
<u>Water Sand</u>	<u>52</u>	

Information upon completion of well:

(1) Diameter 4 inches.

(2) Total Depth 332 feet.

(3) Water Level 104 feet below top of ground.

(4) Cased to 30, Size 4.


(5) Screen: Size , Length .

(6) Were any formations sealed against pollution?
X yes, no.

If YES depth of formation 36 ft

Why to blue dirt

Drillers Remarks:

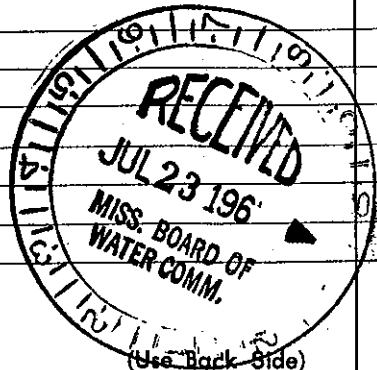

Mail this copy to Board of Water Commissioners 429 Miss. St. Jackson, Miss.

Well No.