

Alcorn
 F53
 8-5-68

MISSISSIPPI
 BOARD OF WATER COMMISSIONERS
 416 North State Street
 Jackson, Mississippi 39201

CODED

WATER WELL DRILLERS LOG

Aug 5 1968 Bonds Alcorn
 date well completed firm name county well located

OWNER: R. L. Alexander
 24 Corinth, Miss
 (mailing address)


description of formations encountered	from	to
Red Clay	0	9
Sandy it	9	20
Blue clay	20	295
Water Sand	295	350

WELL LOCATION:
 sec. 2 T. 2 N. R. 6 E.
 4 miles South of Corinth
 (distance) (direction) (nearest town)

WELL PURPOSE: Home
 (home, irrigation, municipal, industrial)

- WELL COMPLETION DATA:
- diameter (inches) 4"
 - total depth (feet) 350
 - static water level (feet) 185 below top of ground.
 - casing steel 21 (material) (depth)
 4 (size) if telescope see back.
 - screen none (length) (depth to top)
 none (size) (material)
 - pump 2 (HP) 4 1/2 (yield gpm)
 Elect (type power)
 - electric log no (yes or no)
 none (organization running log)
 - how well bottom plugged Open

CODED

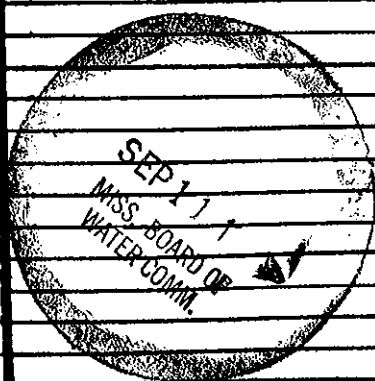

DRILLERS REMARKS: