

Alcorn
F55
10-66

WATER WELL DRILLERS LOG

CODED

Date: Oct 15, 1966, Driller: Bonds

(Name)

(1) Owner of Land: L R Wages
(Name)
Carinth Miss
(Address)

(2) Location: NW 1/4, 1/4, Sec 36 T25R6E
7 miles S west of Carinth
(distance) (direction) (Nearest Town)

(3) Topography: Hilly
(Hilly) (Flat) (Level)

(4) Purpose of Well: Domestic
(Domestic Irrigation
Municipal, Industrial, Other)

Description & Color of Materials Sand, Clay, Red Clay, Shell, etc.	Thick- ness Feet	Depth Feet
<u>Yellow Sand + M. Feel</u>	<u>40</u>	<u>40</u>
<u>Dirt</u>		
<u>200 ft Blue Clay</u>	<u>200</u>	<u>240</u>
<u>White Water Sand</u>	<u>60</u>	<u>300</u>

Information upon completion of well:


- (1) Diameter 4 inches.
- (2) Total Depth 300 feet.
- (3) Water Level 140 feet below top of ground.
- (4) Cased to 42, Size 4
- (5) Screen: Size None Length _____
- (6) Were any formations sealed against pollution?
_____ yes, None no.

If YES depth of formation _____

Why _____

Drillers Remarks: _____

CODED

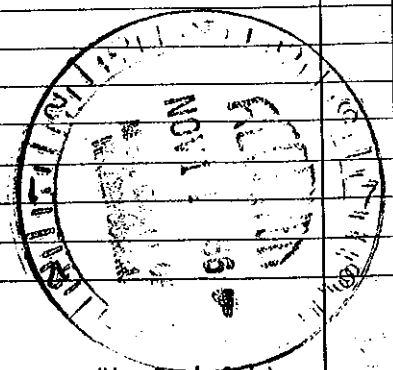

(Use Back Side)

Well No.

Mail this copy to Board of Water Commissioners 429 Miss. St. Jackson, Mi