

Alcorn

RF56

1-67

MISSISSIPPI BOARD OF WATER COMMISSIONERS

WATER WELL DRILLERS LOG

CODED

Date: 1-4, 1967, Driller: Can F. Fairer County Alcorn
(When well drilled) (Name) (Where well is located)

(1) Owner of Land: B.L. Briggs
(Name)
 Hwy 72 W, Corinth, Miss.
(Address)

(2) Location: SE 1/4 SW 1/4, Sec 2 R 10 E
5 miles W of Corinth
(distance) (direction) (Nearest Town)

(3) Topography: (Hilly) (Flat) (Level)

(4) Purpose of Well: Domestic Irrigation Municipal, Industrial, Other

Description & Color of Materials Sand, Clay, Red Clay, Shell, etc.	Thick- ness Feet	Depth Feet
<u>Red Clay</u>	<u>29</u>	
<u>Blue clay</u>	<u>271</u>	<u>300</u>

Information upon completion of well:

(1) Diameter 4" inches.

(2) Total Depth 300 feet.

(3) Water Level 80 feet below top of ground.

(4) Cased to 29', Size 4"

(5) Screen: Size none, Length _____

(6) Were any formations sealed against pollution?
____ yes, ____ no.

If YES depth of formation _____

Why _____

Drillers Remarks: _____


Yield in gpm: 5

Size pump: 1HP. gut

Type power: 220 elec

JUN 20 **CODED**

MISS. BD. OF WATER COMM.

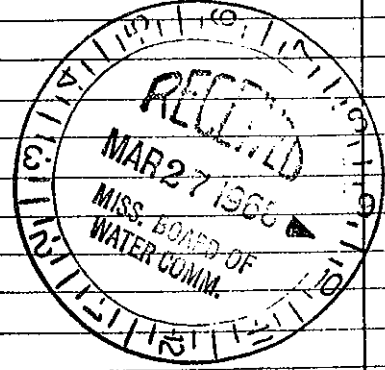

Retain this copy for your office files.