

Alcorn

F 58

4-67

MISSISSIPPI BOARD OF WATER COMMISSIONERS

WATER WELL DRILLERS LOG

CODED

Date: 4-4, 1967, Driller: Carl F. Fain County Alcorn
(When well drilled) (Name) (Where well is located)

(1) Owner of Land:	Description & Color of Materials Sand, Clay, Red Clay, Shell, etc.	Thick- ness Feet	Depth Feet
(Name) <u>Arnie Briggs</u>	<u>Red Clay</u>	<u>161</u>	
(Address) <u>Route - Cornith, Miss</u>	<u>Blue Clay</u>	<u>319</u>	<u>480</u>
(2) Location: <u>SW 1/4 SE 1/4, Sec. 5 T2 R12 E8</u>			
(distance) <u>12</u> miles <u>W</u> , of <u>Cornith</u> (direction) (Nearest Town)			
(3) Topography: <u>(Hilly)</u> (Flat) (Level)			
(4) Purpose of Well: <u>(Domestic Irrigation)</u> Municipal, Industrial, Other			

Information upon completion of well:

- (1) Diameter 4" inches.
- (2) Total Depth 480 feet.
- (3) Water Level 150 feet below top of ground.
- (4) Cased to 161, Size 4"
- (5) Screen: Size None, Length _____
- (6) Were any formations sealed against pollution?
_____ yes, _____ no.

If YES depth of formation _____

Why _____

Drillers Remarks: _____

Yield in gpm: _____


Size pump: 1 H.P.

Type power: 1 H.P. Sub Elec.

CODED

JUN 20 1968

MISS. BD. OF
WATER COMM.

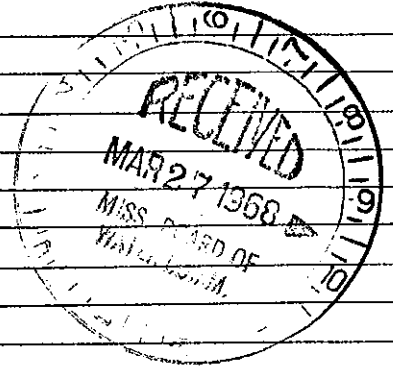

Mail this copy to Board of Water Commissioners 429 Miss. St. Jackson, Miss.