

Alcorn  
759  
6-67

MISSISSIPPI  
BOARD OF WATER COMMISSIONERS  
416 North State Street  
Jackson, Mississippi 39201

**CODED**

WATER WELL DRILLERS LOG

June 30 1967 Bonds Plumbing Alcorn  
date well completed firm name county well located

LANDOWNER: Ray Allen  
Rt 5 Corinth Miss  
(mailing address)


description of formations encountered	from	to
Sandy Clay	0'	19'
Bluest " Strakes	19'	43'
Yellow Sand	43'	100'
Water Sand	110'	122'
Sandy Blue	122'	170'
Bluest Clay	170'	336'
White Sand	336'	400'

WELL LOCATION:  
sec. 28 T 2 N R 6 E  
1 1/2 miles West of Corinth  
(distance) (direction) (nearest town)

WELL PURPOSE: Home  
(home, irrigation, municipal, industrial)

- WELL COMPLETION DATA:
- (1) diameter (inches) 4
  - (2) total depth (feet) 400
  - (3) static water level (feet) 110 below top of ground.
  - (4) casing 5" steel 173 ft (material) (depth)  
4" If telescope see back. (size)
  - (5) screen none (length) (depth to top)  
none (size) (material)
  - (6) pump 1/2 HP 50 (yield gpm)  
Electric (type power)
  - (7) electric log no (yes or no)  
none (organization running log)
  - (8) how well bottom plugged open

**CODED**

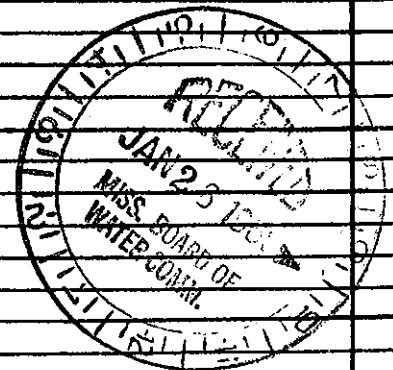

DRILLERS REMARKS: