

ALCORN
F61
12-67

MISSISSIPPI
 BOARD OF WATER COMMISSIONERS
 416 North State Street
 Jackson, Mississippi 39201

CODED

WATER WELL DRILLERS LOG

Dec. 15 1967 date well completed
 Bond Plumbing & Drilling firm name
 Alcorn county well located

LANDOWNER: Brock Phillips

description of formations encountered	from	to
Sandy Clay	0	18
Blue "	13	90
Shale + Sand	90	124
Blue clay	124	390
Water Sand	390	450

(mailing address)

WELL LOCATION:
 sec. 9 T 2 N R 6 E
 S W
 9 miles W of Corinth
 (distance) (direction) (nearest town)

WELL PURPOSE: Home
 (home, irrigation, municipal, industrial)

WELL COMPLETION DATA:

(1) diameter (inches) 4"

(2) total depth (feet) 450

(3) static water level (feet) below top of ground.

(4) casing Steel 126 (material) (depth)
 4" (size) if telescope see back.


(5) screen none (length) (depth to top)

(6) pump none (type power) (material) (yield gpm)

(7) electric log none (yes or no)
 none (organization running log)

(8) how well bottom plugged Open

CODED

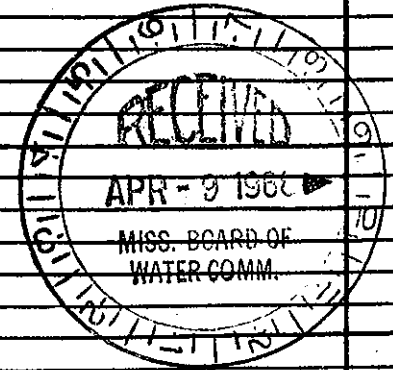

DRILLERS REMARKS: