	State Well R	enort		
County: Akoew	Part 1 - Drille	•	For Office Use Only:	
County:	Mississippi Department of Environmental Quality		Aquifer:	
Permit#:	Office of Land and Water Resources		Well #: F79	
Driller Parks + Parks	P.O. Box 23 Jackson, MS 3		well#.	
Date drilling completed: 8/23/10	(601)961- 52	10	L. S. Elevation:	
Date driffing completed.	(601)961- 5228	(fax)	E-log #:	
State Law requires that this report Department at the above address	t be prepared by the license he within 30 days of completion	lder responsible for i	he work and filed with the	
Information on Well O			rehole Location	
(Landowner if borehole is not fo	r a water well)			
Owner Name KossuTh W			" Longitude: 88 °39 '53 2"	
Mailing Address: 10 CR 6/	3		e): Conventional Survey,	
CORINTA,	MS 38834	SGS quad, Hand-held	GPS, Survey-grade GPS	
	MM	4 5W 4 Sec 15	Twn_25_Rng_6K	
City State	Zip Code Distar	ce Direction Miles	Nearest Town	
Telephone No. (662) 287-43	70	Miles	of KOSSUV 6	
	Well / Borehole Da	ta		
Date drilling started: LIO Date dril	ling completed: 6/2/_ Ho	le depth: 646	Hole diameter: 7 1/8	
Location of the source of any surface water Method of dosing and volume of Chlorine				
Logs run (circle all applicable): No log run Name of organization running log(s): \\ \frac{1}{1} \frac{1}{2}	Electric Gamma Ray Densit	y Sonic Neutron (Other:	
Purpose of borehole (check one): Water We	Geotechnical/Geological In	vectigation Ground	Source Heat Dump	
			source treat tump	
Seismic Se	rveyOther (describe)	31 hole		
1) aruting is not related t	o water well construction skip to	e remainder of this blo	<u>ćk</u>	
Purpose of Well (check one): Home Inc				
If a flowing well, method of flow regulation				
Static Water Level:feet abo	ve or below (circle one) land surfa	ce Date measured:_		
Method of Measurement (circle one) stee				
Well depth: 646 Well grouted to a dep				
Casing length:feet Casing				
Screen length:feet Screen				
Screen slot size:inches	Setting depth: From	feet to	feet	
Type of completion (circle all applicable):	Gravel packed Underreamed	Telescoped Open h	ole Natural Development	
	Other (describe):			

feet. If telescoped or more than one screen, describe on next page

Top of lap pipe or reduction in casing:

Form: OLWR-SWR-1A (04/08)

The sketch	halau.	a= l		6	water wells	
i ne sketci	ı pelow	oniv	reautrea	tor	water weits	


If well telescopes,	show	depths	on	sketch.
Ground Level.		_		

Description of formations encountered must be provided for all wells and boreholes, unless specifically exempted by regulations

Description of Formations Encountered	From (depth)	10 (depth)
	Ground Level	
CIAU	0	180
CAY + LIGNITE	280	320
BANDU CIAU	320	4430
SANA	430	510
· CAH	510	260
Chiak-hard	670	623
	<u> </u>	1
	 	1
		
		
	+	ļ
		ļ
,		
		<u> </u>
	į –	i 1

If more than one screen, show location of each on sketch

Sketch the property layout and include the following: 1) the well location; 2) any permanent structures on the property that may aid in locating the well; 3) any roads, power lines, or other items that may aid in locating the property and the well; 4) a north arrow.

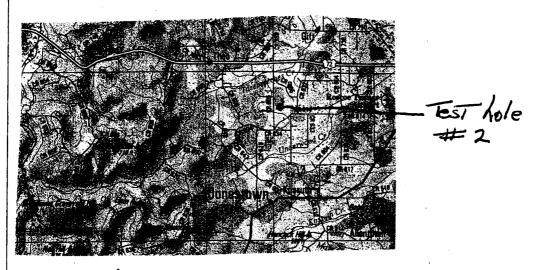

Landowner Name: Rossuth WATER Association

Form: OLWR-SWR-1A (04/08)

I certify that the well/borehole was drilled, constructed, and completed in accordance with all applicable requirements of the Mississippi Department of Environmental Quality and the Mississippi Department of Health regulations, if applicable, and state

Print Name of Responsible Licensee and License No.

8/25/10

Signature of Licenses

DEC 2 0 2010

RV. AI WR