

**ALCORN MISSISSIPPI BOARD OF WATER COMMISSIONERS**

**F**  
 2005  
**3-29-66**

**WATER WELL DRILLERS LOG**

Date: 3-29, 1966, Driller: Chas F. Fair County Alcorn  
 (Name)

(1) Owner of Land: Steve Austin  
 (Name)  
Cornith, Miss.  
 (Address)

(2) Location: \_\_\_\_\_ 1/4, \_\_\_\_\_ 1/4, Sec. \_\_\_\_\_ T. \_\_\_\_\_ R. \_\_\_\_\_  
6 miles W of Cornith  
 (distance) (direction) (Nearest Town)

(3) Topography: (Hilly) (Flat) (Level)

(4) Purpose of Well: (Domestic) Irrigation  
 Municipal, Industrial, Other

Description & Color of Materials Sand, Clay, Red Clay, Shell, etc.	Thick- ness Feet	Depth Feet
<u>Red Clay</u>		<u>29</u>
<u>Blue Clay</u>		<u>231</u>

Information upon completion of well:

(1) Diameter 4" inches.

(2) Total Depth 250 feet.

(3) Water Level 60 feet below top of ground.

(4) Cased to 29', Size 4"


(5) Screen: Size \_\_\_\_\_, Length \_\_\_\_\_.

(6) Were any formations sealed against pollution?  
 yes, \_\_\_\_\_ no.

If YES depth of formation 29'

Why \_\_\_\_\_

Drillers Remarks: \_\_\_\_\_

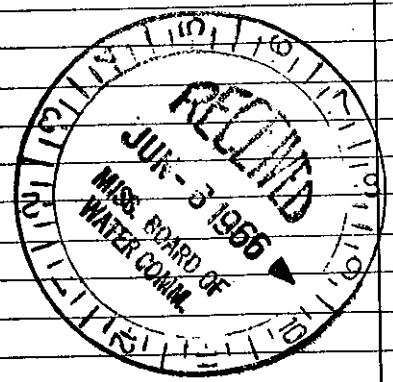

(Use Back Side)