

ALCORN MISSISSIPPI BOARD OF WATER COMMISSIONERS

F 2006
3-9-62

WATER WELL DRILLERS LOG


Date: Mar 9, 1962, Driller: Londs Plumbing Co County: Alcorn
(Name)

(1) Owner of Land:	Description & Color of Materials Sand, Clay, Red Clay, Shale, etc.	Thick- ness Feet	Depth Feet
<u>Coy Yates</u> (Name) <u>Corinth Miss</u> Address	<u>Red Sand</u>	<u>23</u>	
<u>Shiloh Community</u> 1/4, 1/4, Sec. T. R.	<u>Blue + Shell</u>		
<u>8</u> miles <u>west</u> of <u>Corinth</u> (distance) (direction) (Nearest Town)	<u>Same Sand</u>	<u>307</u>	
(3) Topography: <u>Hilly</u> (Hilly) (flat) (Level)	<u>Good water sand</u>	<u>70</u>	
(4) Purpose of Well: <u>Domestic</u> (Domestic Irrigation Municipal, Industrial, Other)			

Information upon completion of well:

- (1) Diameter 4 inches.
- (2) Total Depth 415' feet.
- (3) Water Level 75' feet below top of ground.
- (4) Cased to 22 10" ft, Size 4"
- (5) Screen: Size _____, Length _____.
- (6) Were any formations sealed against pollution?
✓ yes, _____ no.
- If YES depth of formation 22 ft 10"
- Why Sealed To blue

Drillers Remarks:

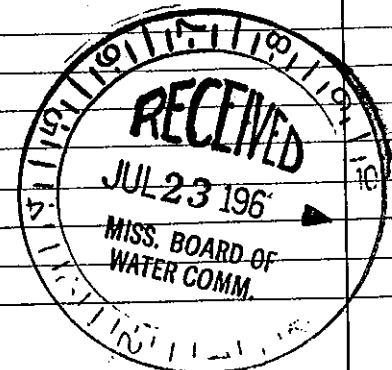

(Use Back Side)

Mail this copy to Board of Water Commissioners 429 Miss. St. Jackson, Miss.