

GW  
00405

Alcorn  
G 64  
6-67

MISSISSIPPI  
BOARD OF WATER COMMISSIONERS  
416 North State Street  
Jackson, Mississippi 39201

WATER WELL DRILLERS LOG

6-23-1967 Layne-Central Company Alcorn  
date well completed firm name county well located

LANDOWNER:  
City of Corinth  
Corinth, Mississippi  
(mailing address)

WELL LOCATION:  
sec. 1 T 2 N R 7 E  
S W

(distance) miles (direction) of (nearest town)

description of formations encountered	from	to
Total Depth 495		
Clay	0	18
soapstone	18	90
sandy shale	90	315
soapstone	315	384
sandy shale	384	422
limestone	422	495

WELL PURPOSE: Municipal  
(home, irrigation, municipal, industrial)

WELL COMPLETION DATA:

(1) diameter (inches) 12"

(2) total depth (feet) 495'

(3) static water level (feet) 123' below above top of ground.


(4) casing T&C, 430'  
(material) (depth)  
12" If telescope see back.  
(size)

(5) screen 60', 432'  
(length) (depth to top)  
8" s.s. shutter  
(size) (material)

(6) pump 125 750  
(HP) (yield gpm)  
Electric  
(type power)

(7) electric log \_\_\_\_\_  
(yes or no)  
\_\_\_\_\_  
(organization running log)

(8) how well bottom plugged \_\_\_\_\_

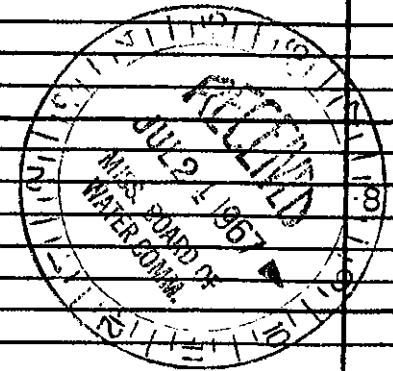

DRILLERS REMARKS: