

Alcorn
G96
9-5-66

MISSISSIPPI
BOARD OF WATER COMMISSIONERS
416 North State Street
Jackson, Mississippi 39201

CODED

WATER WELL DRILLERS LOG

Sept 5 1966 Bonds Alcorn
date well completed firm name county well located

LANDOWNER	description of formations encountered	from	to
Miller & Smith Corinth Miss	yellow clay	top	30
	blue "	30	150
	water sand	150	200


(mailing address)

WELL LOCATION:
sec. 2 T 2 N R 7 E
1 miles West of Corinth
(distance) (direction) (nearest town)

WELL PURPOSE: Home
(home, irrigation, municipal, industrial)

- WELL COMPLETION DATA:
- (1) diameter (inches) 4
 - (2) total depth (feet) 200
 - (3) static water level (feet) 70 below top of ground.
 - (4) casing Steel 32 (material), (depth)
4" (size) if telescope see back.
 - (5) screen none (length) (depth to top)
 - (6) pump didn't install (HP) (material) (yield gpm)
 - (7) electric log no (yes or no)
none (organization running log)
 - (8) how well bottom plugged Open

CODED

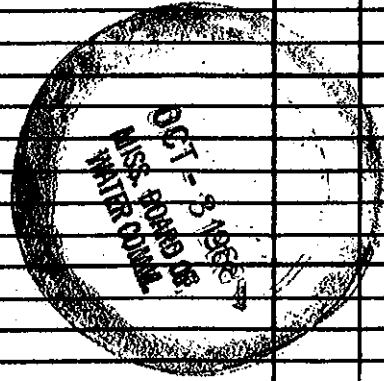

DRILLERS REMARKS: