

MISSISSIPPI BOARD OF WATER COMMISSIONERS

Alcorn
G 97
10-66

WATER WELL DRILLERS LOG

CODED

Date: Oct 7, 1966 Driller: Lilly Bonds County Alcorn
Name

(1) Owner of Land:	Description & Color of Materials Sand, Clay, Red Clay, Shell, etc.	Thick- ness Feet	Dept Feet
<u>Loy C. West</u> (Name) <u>Corinth, Miss</u> (Address)	<u>Red + yellow Sand</u>	<u>80</u>	<u>80</u>
(2) Location <u>1/4, 25 1/4, Sec. 25 T25R7E</u>	<u>Blue</u>	<u>20</u>	<u>100</u>
<u>4</u> miles <u>South</u> of <u>Corinth</u> (distance) (direction) (Nearest Town)	<u>White Water Sand</u>	<u>50</u>	<u>150</u>
(3) Topography: <u>Hilly</u> (Hilly) (Flat) (Level)			
(4) Purpose of Well: <u>Domestic</u> (Domestic Irrigation Municipal, Industrial, Other)			

Information upon completion of well:


- (1) Diameter 4 inches.
- (2) Total Depth 150 feet.
- (3) Water Level 50 feet below top of ground.
- (4) Cased to 84, Size 4"
- (5) Screen: Size none, Length _____
- (6) Were any formations sealed against pollution?
_____ yes, no.

If YES depth of formation _____

Why _____

Drillers Remarks: _____

CODED

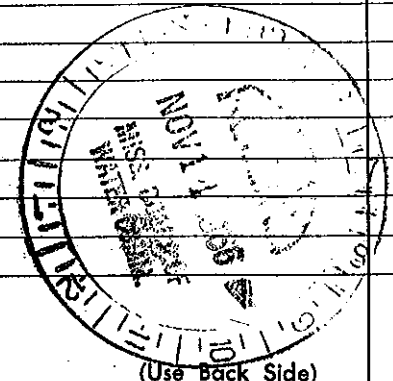

(Use Back Side)

Well No.

Mail this copy to Board of Water Commissioners 429 Miss. St. Jackson, Miss.