

Alcorn
G 99
6-12-68

MISSISSIPPI
 BOARD OF WATER COMMISSIONERS
 416 North State Street
 Jackson, Mississippi 39201

WATER WELL DRILLERS LOG

CODED

June 12 1968 date well completed Bonds firm name Alcorn county well located

LANDOWNER: O. E. Lamberth
Corinth, Miss

description of formations encountered	from	to
<u>Sandy clay</u>	<u>0</u>	<u>9</u>
<u>Sand</u>	<u>9</u>	<u>17</u>
<u>Blue clay</u>	<u>17</u>	<u>85</u>
<u>" " & shell</u>	<u>85</u>	<u>115</u>
<u>Water sand & wood</u>	<u>115</u>	<u>250</u>

(mailing address)

WELL LOCATION:


sec. 17 T. 2 N. R. 7 E. S. W
4 miles NE of Corinth
 (distance) (direction) (nearest town)

WELL PURPOSE: Shed Well
 (home, irrigation, municipal, industrial)

WELL COMPLETION DATA:

- (1) diameter (inches) 4
- (2) total depth (feet) 250
- (3) static water level 6" ^{below} top of ground
- (4) casing Steel 21
 (material) (depth)
4" (size) if telescope see back.
- (5) screen none
 (length) (depth to top)
none (size) (material)
- (6) pump did not install
 (HP) (yield gpm)
- (type power)
- (7) electric log no
 (yes or no)
none (organization running log)
- (8) how well bottom plugged Open

CODED

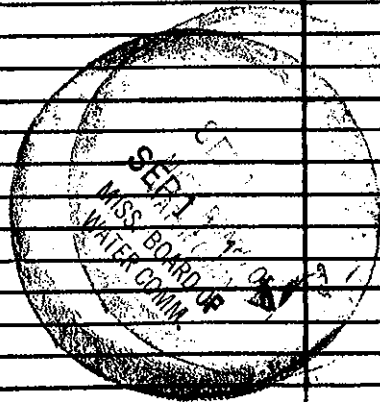

DRILLERS REMARKS:

Tried to get overflow well