

ALCONN

MISSISSIPPI BOARD OF WATER COMMISSIONERS

6  
8-01-65

2000

WATER WELL DRILLERS LOG

Date: Aug, 1965, Driller: Joe Jobe County Alcorn  
(Name)

	Description & Color of Materials Sand, Clay, Red Clay, Shell, etc.	Thick- ness Feet	Depth Feet
(1) Owner of Land: <u>Neil Strickland</u> (Name) <u>Courth, Miss. (72 East)</u> (Address)	<u>Blue Clay</u> <u>Coffee Sand</u>	<u>40</u> <u>55</u>	<u>40</u> <u>95</u>
(2) Location: <u>1/4</u> , <u>1/4</u> , Sec. <u>   </u> T <u>   </u> R <u>   </u> <u>1/4</u> miles <u>South</u> of <u>Courth</u> (distance) (direction) (Nearest Town)			
(3) Topography: <u>Hilly</u> (Hilly) (Flat) (Level)			
(4) Purpose of Well: <u>Domestic</u> (Domestic Irrigation Municipal, Industrial, Other)			


Information upon completion of well:

- (1) Diameter 6 inches.
- (2) Total Depth 95 feet.
- (3) Water Level 7+ feet below top of ground.
- (4) Cased to 20 ft, Size 6"
- (5) Screen: Size    , Length      
Open Hole Well
- (6) Were any formations sealed against pollution?  
    yes,  no.

If YES depth of formation    

Why    

Drillers Remarks:    

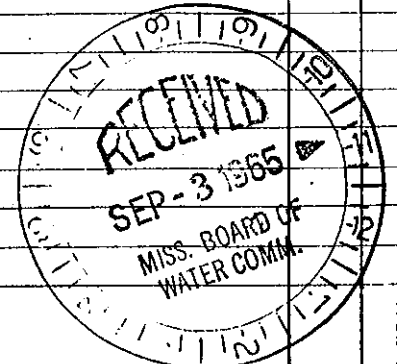

(Use Back Side)

Well No.

Mail this copy to Board of Water Commissioners 429 Miss. St. Jackson, Miss