

Alcorn

MISSISSIPPI BOARD OF WATER COMMISSIONERS

B  
11-64 2008


WATER WELL DRILLERS LOG

Date: 11-22, 1966, Driller: Carl F. Fair County Alcorn  
(When well drilled) (Name) (Where well is located)

		Description & Color of Materials Sand, Clay, Red Clay, Shell, etc.	Thick- ness Feet	Depth Feet
(1) Owner of Land: <u>Brett West</u> (Name)		<u>Red Clay</u>	<u>28</u>	
<u>Rt Cornith Miss</u> (Address)		<u>Blue Clay</u>	<u>172</u>	<u>200</u>
(2) Location: <u>1/4, 1/4, Sec. 17 T. 27 S. R. 8</u>				
<u>5</u> miles <u>S.W.</u> , of <u>Cornith</u> (distance) (direction) (Nearest Town)				
(3) Topography: <input checked="" type="checkbox"/> (Level) (Hilly) (Flat)				
(4) Purpose of Well: <input checked="" type="checkbox"/> Domestic Irrigation (Municipal, Industrial, Other)				
Information upon completion of well:				
(1) Diameter <u>4"</u> inches.				
(2) Total Depth <u>200</u> feet.				
(3) Water Level _____ feet below top of ground.				
(4) Cased to <u>28'</u> , Size <u>4"</u>				
(5) Screen: Size <u>None</u> , Length _____				
(6) Were any formations sealed against pollution? _____ yes, _____ no.				
If YES depth of formation _____				
Why _____				
Drillers Remarks: _____				
Yield in gpm: _____				
Size pump: <del>200</del> <u>1/2 gal</u>				
Type power: <u>220</u> <u>Elc</u>				

JUN 20 1968

MISS. BD. OF WATER COMM.

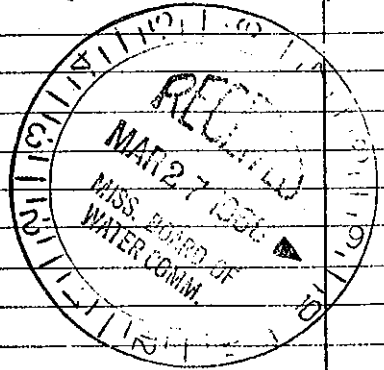

Retain this copy for your office files.