

Alcorn
G 2016
7-68

MISSISSIPPI
 BOARD OF WATER COMMISSIONERS
 416 North State Street
 Jackson, Mississippi 39201

WATER WELL DRILLERS LOG


7-9 1968 Faires Well Supply Alcorn
 date well completed firm name county well located

LANDOWNER	description of formations encountered	from	to
<u>Jimie Honeycutt</u>			
<u>Route 4</u>			
<u>Cornith Miss</u> (mailing address)	<u>Red Clay & Sand</u>	<u>0</u>	<u>22 1/2</u>
		<u>22 1/2</u>	<u>180</u>

WELL LOCATION:
 sec. 18 T. 2 N. R. 7 E.
 S
5 miles W of Cornith
 (distance) (direction) (nearest town)

WELL PURPOSE:
 (home, irrigation, municipal, industrial)
home

- WELL COMPLETION DATA:
- (1) diameter (inches) 4
 - (2) total depth (feet) 180
 - (3) static water level (feet) _____ below above top of ground.
 - (4) casing Steel 22 1/2
 (material) (depth)
 _____ If telescope see back.
 (size)
 - (5) screen None
 (length) (depth to top)
 _____ (size) _____ (material)
 - (6) pump 1/2 3
 (HP) (yield gpm)
Elc
 (type power)
 - (7) electric log _____ (yes or no)
 _____ (organization running log)
 - (8) how well bottom plugged _____

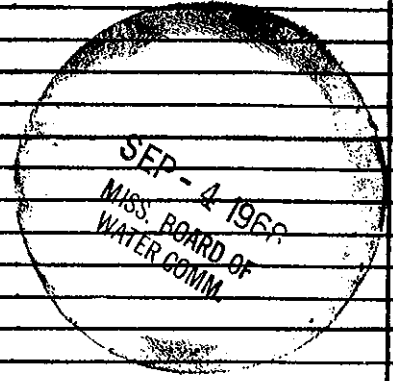

DRILLERS REMARKS:

