

Alcon  
 H95 ~~0192~~  
 8-68

MISSISSIPPI  
 BOARD OF WATER COMMISSIONERS  
 416 North State Street  
 Jackson, Mississippi 39201

**CODED**

WATER WELL DRILLERS LOG

8-9 1968 Corinth Well Drill Alcon  
 date well completed firm name county well located

LANDOWNER: Jimmy Felker  
 Route 6 Box 1  
 (mailing address)


WELL LOCATION:  
 sec. ~~0192~~ 2 N R 8 E  
 S #  
 5 1/2 miles S-E of CORINTH  
 (distance) (direction) (nearest town)

WELL PURPOSE: NONE  
 (home, irrigation, municipal, industrial)

WELL COMPLETION DATA:  
 (1) diameter (inches) 4"  
 (2) total depth (feet) 135  
 (3) static water level (feet) below top of ground.  
 (4) casing PVC, 135 (material), (depth)  
 4" (size) if telescope see back.  
 (5) screen 20 20 (length), (depth to top)  
 4" PVC Sanded (size), (material)  
 (6) pump 3/4 380 (HP), (yield gpm)  
 Electric (type power)  
 (7) electric log (yes or no)  
 (organization running log)  
 (8) how well bottom plugged Gravel

description of formations encountered	from	to
Clay	0	40
sand	40	60
rock	60	62
sand	62	70
Blue clay	70	105
W. Sand	105	135

**CODED**

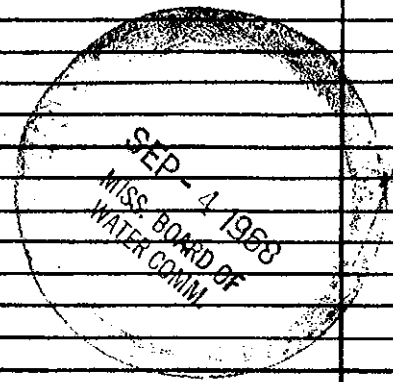

DRILLERS REMARKS: