

Alcorn
H-96
8-68

MISSISSIPPI
 BOARD OF WATER COMMISSIONERS
 416 North State Street
 Jackson, Mississippi 39201

CODED

WATER WELL DRILLERS LOG

8-24 1968 Corinth Well Driller Alcorn
 date well completed film name county well located

LANDOWNER: Billy Haynie
Route 6 Corinth
Miss
 (mailing address)


description of formations encountered	from	to
<u>Red Clay</u>	<u>0</u>	<u>45</u>
<u>Rock</u>	<u>45</u>	<u>48</u>
<u>Sand</u>	<u>48</u>	<u>68</u>
<u>Blue Clay</u>	<u>68</u>	<u>145</u>
<u>Sand</u>	<u>145</u>	<u>170</u>

WELL LOCATION:
 sec. 27 T. 2 N. R. 8 E.
7 miles S.E. of CORINTH
 (distance) (direction) (nearest town)

WELL PURPOSE: Home
 (home, irrigation, municipal, industrial)

- WELL COMPLETION DATA:
- diameter (inches) 4"
 - total depth (feet) 175
 - static water level (feet) 100 below top of ground.
 - casing PVC (material), 125 (depth), 155 (depth)
4" (size) If telescope see back, 155
 - screen 20' (length), 20 (depth to top)
4" (size), PVC Sand (material)
 - pump 3/4 (HP), 300 (yield gpm)
Electric (type power)
 - electric log (yes or no) _____
 (organization running log) _____
 - how well bottom plugged None

CODED

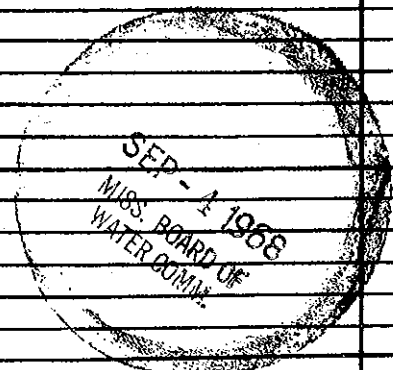

DRILLERS REMARKS: