

HLCKN

H134
3/81

GW
13070

Bureau of Land and Water Resources

Southport Mall
P.O. Box 10631
Jackson, Mississippi 39209
WATER WELL DRILLERS LOG

Lic #
0-418

3 1981 Wilson's Inc Alcorn
date well completed firm name county well located

LANDOWNER:
Farmington Water Assn
Corinth Ms
(mailing address)


| description of formations encountered | from | to |
|---------------------------------------|------|-----|
| Red clay | 0 | 40 |
| " " Rock | 40 | 60 |
| Blue " | 60 | 100 |
| " " + Rock | 100 | 120 |
| " " Lignite + sand rock | 120 | 140 |
| " " + Sand | 140 | 180 |
| Sand + rock | 180 | 200 |
| Sand, rock, blue clay | 200 | 220 |
| lignite, blue clay + rock | 220 | 320 |
| Sand, rock + clay | 320 | 380 |
| Sand + lignite | 380 | 400 |
| Sand + rock | 400 | 440 |
| Gravel + sand | 440 | 480 |
| Gravel | 480 | 500 |
| Rock | 500 | 546 |

WELL LOCATION:
sec. 10 T. 2 N R 8 E
0 miles Farmington Five Dpt.
(distance) (direction) (nearest town)

WELL PURPOSE: Municipal
(home, irrigation, municipal, industrial)

- WELL COMPLETION DATA:
- diameter (inches) 12
 - total depth (feet) 460
 - static water level (feet) 126 below top of ground.
 - casing BIK 355 (material) (depth)
12" (size) If telescope see back.
 - screen 65 320 (length) (depth to top)
8" (size) stainless steel (material)
 - pump 75 590 @ 12 PSI (HP) (yield gpm)
Elec (type power)
 - electric log yes (yes or no)
Miss Geological Survey (organization running log)
 - how well bottom plugged Back-wash valve + concrete plug

CODED

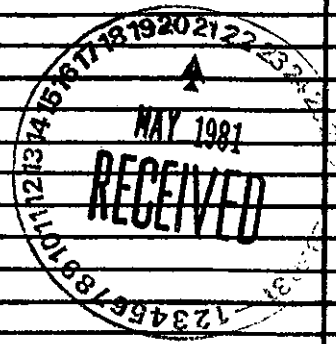

DRILLERS REMARKS: