

H 2000

7- -65

WATER WELL DRILLERS LOG

Date: July, 1965, Driller: Joe Jobe County Alcorn
(Name)

(1) Owner of Land:	Description & Color of Materials Sand, Clay, Red Clay, Shell, etc.	Thick- ness Feet	Depth Feet
<u>Johnny Rast</u> (Name) <u>Rt. 4 - Corinth, Miss.</u> (Address)	<u>Red Clay + Sand Mixed</u> <u>Coffee Sand</u>	<u>80</u> <u>33</u>	<u>80</u> <u>113</u>
(2) Location: <u>1/4</u> , <u>1/4</u> , Sec. <u>T R</u> <u>2 1/2</u> miles <u>SE</u> of <u>Corinth</u> (distance) (direction) (Nearest Town)			
(3) Topography: <u>Hilly</u> (Hilly) (Flat) (Level)			
(4) Purpose of Well: <u>Domestic</u> (Domestic Irrigation Municipal, Industrial, Other)			


Information upon completion of well:

- (1) Diameter 8 inches.
- (2) Total Depth 113 feet.
- (3) Water Level 50 feet below top of ground.
- (4) Cased to 93 ft, Size 4"
- (5) Screen: Size 4" Length 20 ft
Gravel Packed
- (6) Were any formations sealed against pollution?
_____ yes, no.

If YES depth of formation _____

Why _____

Drillers Remarks: _____

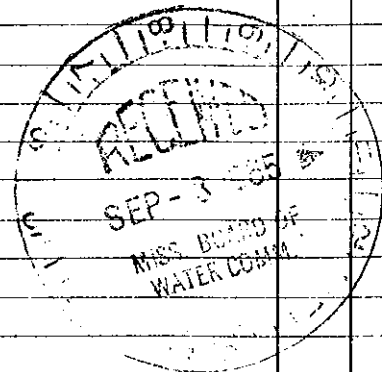

(Use Back Side)

Well No.