

H 2001

## 8- -65 WATER WELL DRILLERS LOG

Date: Aug, 1965, Driller: Joe Jobe County: Alcorn  
(Name)

(1) Owner of Land:	Description & Color of Materials Sand, Clay, Red Clay, Shell, etc.		Thick- ness Feet	Depth Feet
	(Name)			
<u>Curtis Grimes</u> (Name) <u>Corinth, Miss.</u> (Address)	<u>Yellow Sand + Sand Rocks</u>	<u>150</u>	<u>150</u>	
	<u>Coffee Sand</u>	<u>20</u>	<u>170</u>	
(2) Location: <u>1/4</u> , <u>1/4</u> , Sec. <u>T</u> <u>R</u> <u>4</u> miles <u>East</u> , of <u>Corinth</u> (distance) (direction) (Nearest Town)				
(3) Topography: <u>Hilly</u> (Hilly) (Flat) (Level)				
(4) Purpose of Well: <u>Domestic</u> (Domestic Irrigation Municipal, Industrial, Other)				


## Information upon completion of well:

- (1) Diameter 8 inches.
- (2) Total Depth 170 feet.
- (3) Water Level 60 feet below top of ground.
- (4) Cased to 150 ft, Size 4"
- (5) Screen: Size 4", Length 20 ft  
Gravel Packed
- (6) Were any formations sealed against pollution?  
\_\_\_\_\_ yes,  no.

If YES depth of formation \_\_\_\_\_

Why \_\_\_\_\_

Drillers Remarks: \_\_\_\_\_

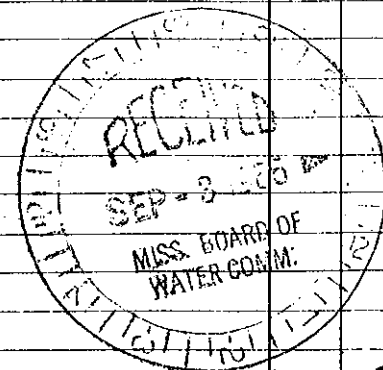

(Use Back Side)

Well No.