

H 2082

8-65 WATER WELL DRILLERS LOG

Date: Aug, 1965, Driller: Joe Jobe County Alcon
(Name)

(1) Owner of Land:	Description & Color of Materials Sand, Clay, Red Clay, Shell, etc.	Thick- ness Feet	Depth Feet.
<u>Thurston Little</u>	<u>Red Sand</u>	<u>65</u>	<u>65</u>
<u>Corinth, Miss.</u>	<u>Copper Sand</u>	<u>20</u>	<u>85</u>
(2) Location: _____ 1/4, _____ 1/4, Sec. _____ T _____ R _____			
<u>1 1/2</u> miles <u>SE</u> , of <u>Corinth</u>			
(distance) (direction) (Nearest Town)			
(3) Topography: _____			
<u>Hilly</u>			
(Hilly) (Flat) (Level)			
(4) Purpose of Well: _____			
<u>Domestic</u>			
(Domestic Irrigation Municipal, Industrial, Other)			


Information upon completion of well:

- (1) Diameter 8 inches.
- (2) Total Depth 85 feet.
- (3) Water Level 5.2 feet below top of ground.
- (4) Cased to 65 ft, Size 4"
- (5) Screen: Size 4", Length 20 ft
Gravel Packed
- (6) Were any formations sealed against pollution?
_____ yes, no.

If YES depth of formation _____

Why _____

Drillers Remarks: _____

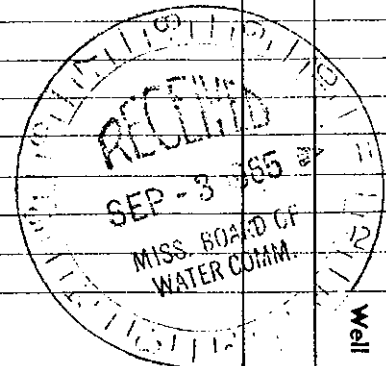

(Use Back Side)

Well No