

ALCORN

MISSISSIPPI BOARD OF WATER COMMISSIONERS

H 2003

2-21-66

WATER WELL DRILLERS LOG

Date: ~~2~~ 21, 1966, Driller: Con F. Fairer County Alcorn
(Name)

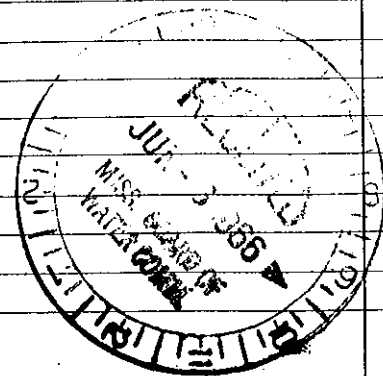
(1) Owner of Land:	Description & Color of Materials Sand, Clay, Red Clay, Shell, etc.	Thick- ness Feet	Depth Feet
<u>Pete Childers</u> (Name) <u>Rt. Cornith, Miss</u> (Address)	<u>Sand</u>		<u>100</u>
(2) Location: <u>1/4</u> , <u>1/4</u> , Sec. <u>T</u> <u>R</u> <u>10</u> miles <u>E</u> , of <u>Cornith</u> (distance) (direction) (Nearest Town)			
(3) Topography: <u>(Hilly)</u> (Flat) (Level)			
(4) Purpose of Well: <u>(Domestic)</u> Irrigation Municipal, Industrial, Other			

Information upon completion of well:

- (1) Diameter 4 inches.
- (2) Total Depth 100 feet.
- (3) Water Level 50 feet below top of ground.
- (4) Cased to 100', Size 4"
- (5) Screen: Size 4", Length 10'
- (6) Were any formations sealed against pollution?
_____ yes, _____ no.

If YES depth of formation _____

Why _____

Drillers Remarks: Wall of well
between casing backfilled
with sand

Well