

Alcorn
J69
8-67

MISSISSIPPI
BOARD OF WATER COMMISSIONERS
416 North State Street
Jackson, Mississippi 39201

CODED

WATER WELL DRILLERS LOG

Aug 9 1967 *Lombard & Williams* Alcorn
date well completed firm name county well located

LANDOWNER *Ms. O.C. Wilburn*
Rt 4 Corinth
Miss
(mailing address)

description of formations encountered	from	to
<i>Sandy Clay + Blue Sand</i>	<i>0'</i>	<i>49'</i>
<i>Blk Clay</i>	<i>49'</i>	<i>370'</i>
<i>Water Sand</i>	<i>370'</i>	<i>390'</i>


WELL LOCATION:
sec. *12* T *5* N R *6* E
2 miles *S* of *Corinth*
(distance) (direction) (nearest town)

WELL PURPOSE: *Home*
(home, irrigation, municipal, industrial)

- WELL COMPLETION DATA:
- (1) diameter (inches) *4"*
 - (2) total depth (feet) *390"*
 - (3) static water level (feet) *160* below/above top of ground.
 - (4) casing *Blk Steel* *50*
(material) (depth)
4"
(size) If telescope see back.
 - (5) screen *none*
(length) (depth to top)
none
(size) (material)
 - (6) pump *2* *4"*
(HP) (yield gpm)
Elect Jet
(type power)
 - (7) electric log *no*
(yes or no)

(organization running log)
 - (8) how well bottom plugged *open*

CODED

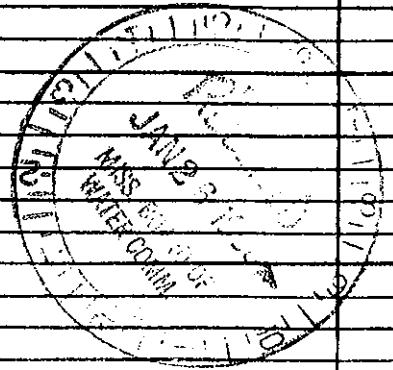

DRILLERS REMARKS: