

ALCORN
 570
 11-67

MISSISSIPPI
 BOARD OF WATER COMMISSIONERS
 416 North State Street
 Jackson, Mississippi 39201

CODED

WATER WELL DRILLERS LOG

Nov 15 1967 date well completed
 G. Bonds Plumbing & Drilling Co. firm name
 Alcorn county well located

LANDOWNER: Daniel Hamlin
Route 1
Keosauqua, Miss
 (mailing address)


description of formations encountered	from	to
Red Sandy clay	0	34
5' sand & clay	34	40
Blue Clay	40	32
Water Sand	320	400

WELL LOCATION:
 sec 21 T 4 N R 6 E
3 S W
5 miles S of Keosauqua
 (distance) (direction) (nearest town)

WELL PURPOSE: Home
 (home, irrigation, municipal, industrial)

- WELL COMPLETION DATA:
- (1) diameter (inches) 4"
 - (2) total depth (feet) 460 ft
 - (3) static water level (feet) 130' below top of ground
 - (4) casing 42 (material) (depth)
4" (size) if telescope see back.
 - (5) screen None (length) None (depth to top)
 - (6) pump 1 HP (type power) 1000 (yield gpm)
 - (7) electric log Yes (yes or no)
 - (8) how well bottom plugged Open

CODED

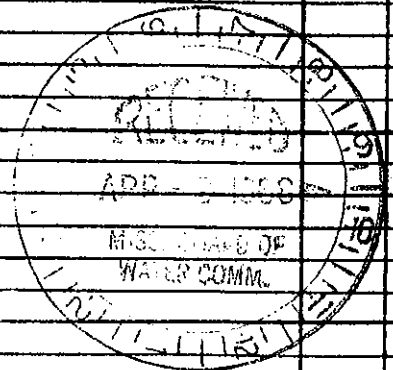

DRILLERS REMARKS: