

ALCORN MISSISSIPPI BOARD OF WATER COMMISSIONERS

J 2000

WATER WELL DRILLERS LOG

J300

10-17-60


Date: 10 - 17, 19 60, Driller: Con T. Faires County Alcorn
(Name)

| | Description & Color of Materials Sand, Clay, Red Clay, Shell, etc. | Thick- ness Feet | Depth Feet |
|--|---|------------------------|---------------|
| (1) Owner of Land: Austin Lovell (Name) | Red Clay & Rock | | 20 |
| Rienzi, Mississippi (Address) | Blue Clay & Rock | | 210 |
| (2) Location: 1/4, 1/4, Sec. T R | | | |
| 4 miles West of Rienzi (distance) (direction) (Nearest Town) | | | |
| (3) Topography: Hilly (Hilly) (Flat) (Level) | | | |
| (4) Purpose of Well: Domestic (Domestic Irrigation Municipal, Industrial, Other) | | | |

Information upon completion of well:

- (1) Diameter 4 inches.
- (2) Total Depth 250 feet.
- (3) Water Level 128 feet below top of ground.
- (4) Cased to 21, Size 4"
- (5) Screen: Size, Length
- (6) Were any formations sealed against pollution?
Yes yes, no.
- If YES depth of formation 21
- Why

Drillers Remarks:

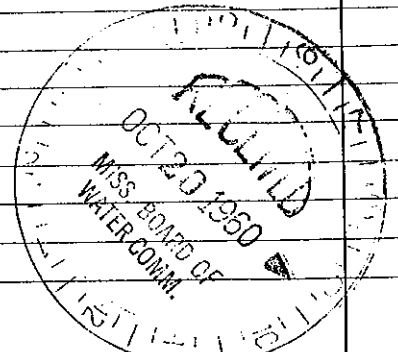

(Use Back Side)

Well No. J300