

ALCORN MISSISSIPPI BOARD OF WATER COMMISSIONERS

J 2001

WATER WELL DRILLERS LOG

2-3-62

Date: Feb 3 1962 Driller: RC Bonds County Alcorn

**BONDS PLUMBING & DRILLING CO.**


(1) Owner of Land:	Description & Color of Materials Sand, Clay, Red Clay, Shell, etc.	Thick- ness Feet	Depth Feet
<u>LC Fralin</u> (Name) <u>Kassuth Miss</u> (Address)	<u>Red Sand</u>	<u>44</u>	
(2) Location: <u>1/4</u> , <u>1/4</u> , Sec. <u>   </u> T. <u>   </u> R. <u>   </u>	<u>206 ft Blue</u>	<u>206</u>	
<u>3</u> miles <u>South</u> of <u>Kassuth</u> (distance) (direction) (Nearest Town)	<u>45 Shells</u>	<u>45</u>	
(3) Topography: <u>   </u> (Hill) <u>   </u> (Flat) <u>   </u> (Level)	<u>Water Sand</u>	<u>176</u>	
(4) Purpose of Well: <u>Domestic</u> (Domestic Irrigation Municipal, Industrial, Other)	<u>Total</u>	<u>388</u>	
	<u>Red Sand</u>	<u>45</u>	
	<u>Water Sand</u>	<u>67</u>	
	<u>Shells + Blue</u>	<u>276</u>	
		<u>388</u>	

Information upon completion of well:

- (1) Diameter 4 inches.
- (2) Total Depth 388 feet.
- (3) Water Level 176 feet below top of ground.
- (4) Cased to 45 ft, Size 4"
- (5) Screen: Size none, Length
- (6) Were any formations sealed against pollution?  
45 ft 3" yes,     no.

If YES depth of formation to Blue  
Why    

Drillers Remarks: Good water  
Sand 67 ft.

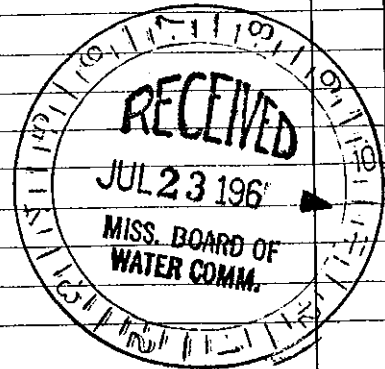

(Use Back Side)

Mail this copy to Board of Water Commissioners 429 Miss. St. Jackson, Mi

Well No.