

ALCORN MISSISSIPPI BOARD OF WATER COMMISSIONERS

J 2002
2-12-62

WATER WELL DRILLERS LOG

Date: Feb 13, 1962 Driller: Bonds P & Co County Prenlist
(Name)


(1) Owner of Land:	Description & Color of Materials Sand, Clay, Red Clay, Shell, etc.	Thick- ness Feet	Depth Feet
<u>A J Crumb</u> (Name) <u>Pringi Mick</u> (Address)	<u>Red Sand & Clay</u>	<u>37</u>	
(2) Location: _____ 1/4, _____ 1/4, Sec. _____ T R _____	<u>Blue</u>	<u>280</u>	
<u>6</u> miles <u>South</u> of <u>Kassith</u> (distance) (direction) (Nearest Town)	<u>water sand</u>	<u>61</u>	
(3) Topography: <u>Hilly</u> (Hilly) (Flat) (Level)			
(4) Purpose of Well: <u>Domestic</u> (Domestic Irrigation Municipal, Industrial, Other)			

Information upon completion of well:

- (1) Diameter 4" inches.
- (2) Total Depth 388 feet.
- (3) Water Level 188 feet below top of ground.
- (4) Cased to 38, Size 4"
- (5) Screen: Size _____, Length _____
- (6) Were any formations sealed against pollution?
_____ yes, yes no.

If YES depth of formation 280 ft
Why Through Blue

Drillers Remarks:

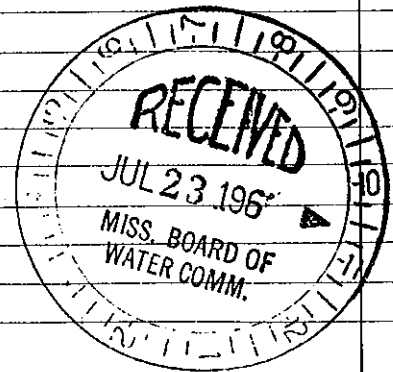

(Use Back Side)

Mail this copy to Board of Water Commissioners 429 Miss. St. Jackson, Miss.