

Alcorn


MISSISSIPPI BOARD OF WATER COMMISSIONERS

T 2003  
9-66

WATER WELL DRILLERS LOG

Date: Sept 9, 1966, Driller: BONDS PLUMBING & DRILLING CO. County Alcorn  
(Name)

(1) Owner of Land:	Description & Color of Materials Sand, Clay, Red Clay, Shell, etc.	Thick- ness Feet	Depth Feet
<u>Ellic Hardin</u> (Name) <u>Rienzi Miss</u> (Address)	<u>mixed dirt</u>	<u>18</u>	
(2) Location: <u>NW</u> , <u>1/4</u> , Sec. <u>46</u> <u>T5 R E</u>	<u>Blue clay</u>	<u>92</u>	
<u>7</u> miles <u>west</u> of <u>Rienzi</u> (distance) (direction) (Nearest Town)	<u>white water sand</u>	<u>60</u>	<u>170</u>
(3) Topography: <u>Flat</u> (Hilly) (Flat) (Level)			
(4) Purpose of Well: <u>Domestic</u> (Domestic Irrigation Municipal, Industrial, Other)			
Information upon completion of well:			
(1) Diameter <u>4</u> inches.			
(2) Total Depth <u>170</u> feet.			
(3) Water Level <u>90</u> feet below top of ground.			
(4) Cased to <u>21</u> , Size <u>4</u>			
(5) Screen: Size _____, Length _____			
(6) Were any formations sealed against pollution?			
_____ yes, _____ no.			
If YES depth of formation _____			
Why _____			
Drillers Remarks: _____			
_____			
_____			
_____			

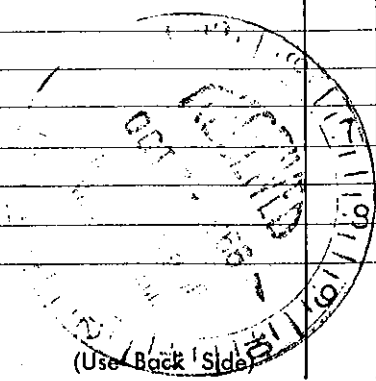

Well No.

Mail this copy to Board of Water Commissioners 429 Miss. St. Jackson, Mis