

MISSISSIPPI BOARD OF WATER COMMISSIONERS

Alcorn  
T 2004  
9-66

WATER WELL DRILLERS LOG

Date: 19, 1966, Driller: BONDS PLUMBING & DRILLING CO County: Alcorn  
(Name)

		Description & Color of Materials Sand, Clay, Red Clay, Shell, etc.	Thick- ness Feet	Depth Feet
(1) Owner of Land: <u>Kathline Suter</u> (Name)				
<u>Rienzi Miss</u> (Address)		<u>ripped dirt</u>	<u>18</u>	
(2) Location: <u>NW 1/4</u> , Sec. <u>4</u> T. <u>4</u> R. <u>15</u>		<u>Sandy blue</u>	<u>85</u>	
<u>6</u> miles <u>West</u> of <u>Rienzi</u> (distance) (direction) (Nearest Town)		<u>50 ft Water Sand</u>	<u>52</u>	<u>150</u>
(3) Topography: <u>Flat</u> (Hilly) (Flat) (Level)				
(4) Purpose of Well: <u>Domestic</u> (Domestic Irrigation Municipal, Industrial, Other)				


Information upon completion of well:

- (1) Diameter 4 inches.
- (2) Total Depth 150 feet.
- (3) Water Level 70 feet below top of ground.
- (4) Cased to 21, Size 4"
- (5) Screen: Size \_\_\_\_\_, Length \_\_\_\_\_
- (6) Were any formations sealed against pollution?  
\_\_\_\_\_ yes, \_\_\_\_\_ no.

If YES depth of formation \_\_\_\_\_

Why \_\_\_\_\_

Drillers Remarks: \_\_\_\_\_

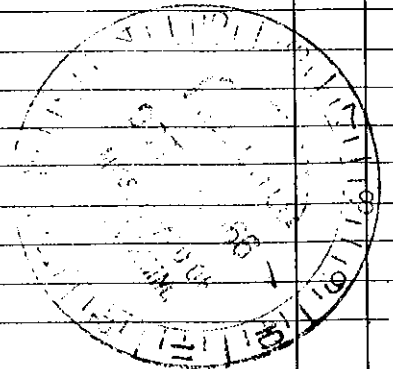

(Use Back Side)

Well No.

Mail this copy to Board of Water Commissioners 429 Miss. St. Jackson, Miss