

Alcorn
K 54
11-68

MISSISSIPPI
 BOARD OF WATER COMMISSIONERS
 416 North State Street
 Jackson, Mississippi 39201

WATER WELL DRILLERS LOG

date well completed 19 68 firm name Bonds county well located Alcorn

LANDOWNER: John L. Dersell
Rt 2 Kenzi
Miss
 (mailing address)

description of formations encountered	from	to
<u>Sand + Clay</u>	<u>0</u>	<u>19</u>
<u>Blue</u>	<u>19</u>	<u>38</u>
<u>Red Sand</u>	<u>38</u>	<u>60</u>
<u>Water Sand</u>	<u>60</u>	<u>96</u>
<u>Blue Clay</u>	<u>96</u>	<u>135</u>
<u>Water Sand</u>	<u>135</u>	<u>200</u>

WELL LOCATION:
 sec. 3 T. 4 N. R. 7 E.
3/4 miles West of Kenzi
 (distance) (direction) (nearest town)

WELL PURPOSE: Home
 (home, irrigation, municipal, industrial)

WELL COMPLETION DATA:

(1) diameter (inches) 4"

(2) total depth (feet) 200

(3) static water level (feet) 63 below above top of ground.

(4) casing Steel 105'
 (material) (depth)

4 If telescope see back.
 (size)

(5) screen none
 (length) (depth to top)

(size) (material)

(6) pump 3/4 6 PM
 (HP) (yield gpm)


Elect
 (type power)

(7) electric log (yes or no)

(organization running log)

(8) how well bottom plugged Open

DRILLERS REMARKS:

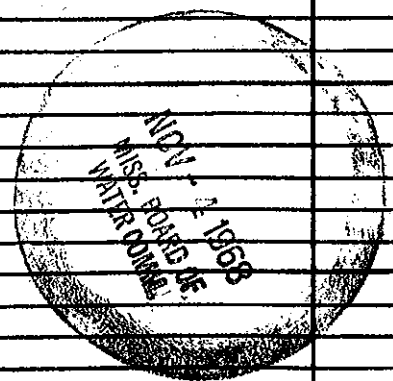

CODED

CODED