

Alcorn  
K77  
11-66

MISSISSIPPI BOARD OF WATER COMMISSIONERS

WATER WELL DRILLERS LOG

Date: Nov 22, 1966, Driller: Bond Plumbing Co.  
(Name)

**CODED**

(1) Owner of Land:	Description & Color of Materials Sand, Clay, Red Clay, Shell, etc.	Thick- ness Feet	Depth Feet
<u>Tremor Dawson</u> (Name)	<u>yellow sand</u>	<u>50</u>	<u>50</u>
<u>Rienzi Miss</u> (Address)	<u>Sandy Blue</u>	<u>60</u>	<u>110</u>
	<u>water sand</u>	<u>40</u>	<u>150</u>
(2) Location: <u>1/4</u> <u>NE</u> <u>1/4</u> , Sec. <u>3</u> T4S R7E			
<u>1/4</u> miles <u>west</u> of <u>Rienzi</u> (distance) (direction) (Nearest Town)			
(3) Topography: <u>Hilly</u> (Hilly) (Flat) (Level)			
(4) Purpose of Well: <u>Home</u> (Domestic Irrigation Municipal, Industrial, Other)			

Information upon completion of well:

- (1) Diameter 4 inches.
- (2) Total Depth 150 feet.
- (3) Water Level 2 feet below top of ground.
- (4) Cased to 52, Size 4"
- (5) Screen: Size None, Length \_\_\_\_\_
- (6) Were any formations sealed against pollution?  
\_\_\_\_\_ yes, \_\_\_\_\_ no.


If YES depth of formation \_\_\_\_\_

Why \_\_\_\_\_

Drillers Remarks: \_\_\_\_\_

Retain this copy for your office files.

**CODED**

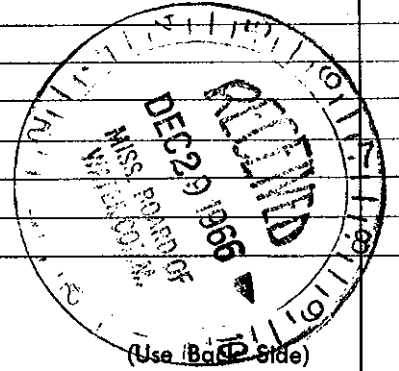

Well No.