

Alcorn
K78
1-67

MISSISSIPPI
BOARD OF WATER COMMISSIONERS
416 North State Street
Jackson, Mississippi 39201

CODED

WATER WELL DRILLERS LOG

Jan 12 1967 date well completed
Bonds Plumbing & Drilling Co. firm name
Alcorn county well located

LANDOWNER: Mark Dellumith
Route 1
Rengi Miss
(mailing address)


description of formations encountered	from	to
Sandy Loam	0	6
Gray clay	6	16
Yellow sand	16	20
Hard blue clay & shells	20	180
Water sand	180	215

WELL LOCATION:
sec. 7 T. 3 N R. 7 E.
2 miles West of Biggsville
(distance) (direction) (nearest town)

WELL PURPOSE: home
(home, irrigation, municipal, industrial)

- WELL COMPLETION DATA:
- diameter (inches) 4"
 - total depth (feet) 215
 - static water level (feet) 80' below top of ground.
 - casing (material) 4" (depth) 21' If telescope see back. (size)
 - screen (length) (depth to top) (size) (material)
 - pump (HP) 3 (yield gpm) 5
(type power) elect
 - electric log no (yes or no)
(organization running log)
 - how well bottom plugged open

CODED

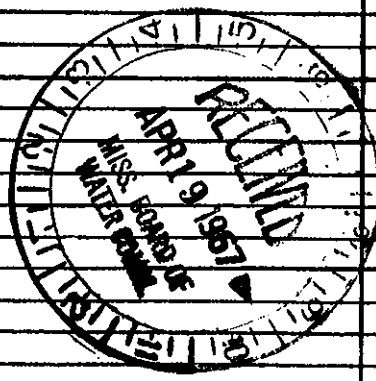

DRILLERS REMARKS: