

Alcorn  
 183  
 7-31-68

MISSISSIPPI  
 BOARD OF WATER COMMISSIONERS  
 416 North State Street  
 Jackson, Mississippi 39201

WATER WELL DRILLERS LOG

**CODED**

July 31 1968 Bonds  
 date well completed firm name county well located


LANDOWNER	description of formations encountered	from	to
Brady Meeks	Red clay	0	5
St. Remy's Miss	Sandst	5	37
	Blue clay	37	165
	Water sand	165	220

(mailing address)  
 WELL LOCATION:  
 Sec. 20 T. 3 N. R. 7 E.  
 0.3 miles S of Biggsville

WELL PURPOSE: Home  
 (home, irrigation, municipal, industrial)

- WELL COMPLETION DATA:
- diameter (inches) 4
  - total depth (feet) 220
  - static water level (feet) 90 below top of ground.
  - casing Steel 4 1/2" (material) 42' (depth)  
 4" (size) If telescope see back.
  - screen none (length) (depth to top)  
 none (size) (material)
  - pump 1 (HP) 5 (yield gpm)  
 Elect (type power)
  - electric log No (yes or no)  
 none (organization running log)
  - how well bottom plugged Open

**CODED**

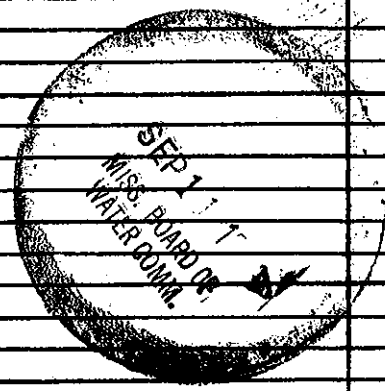

DRILLERS REMARKS: