

Alcorn

K 2005

8-17-66

MISSISSIPPI BOARD OF WATER COMMISSIONERS

WATER WELL DRILLERS LOG

Date: Aug 17, 19 66 Driller: Bonds County: Prentiss


Owner of Land: Thomas Allen, Biggersville; Location: 3 miles west; Topography: Hill; Purpose of Well: Domestic Irrigation

Table with 3 columns: Description & Color of Materials, Thickness Feet, Depth Feet. Entries include yellow sand, 110 ft blue clay & shells, water sand.

Information upon completion of well:

- (1) Diameter 4 inches. (2) Total Depth 170 feet. (3) Water Level 63 feet below top of ground. (4) Cased to 21, Size 4. (5) Screen: Size, Length. (6) Were any formations sealed against pollution?

If YES depth of formation, Why, Drillers Remarks, Yield in gpm, Size pump, Type power

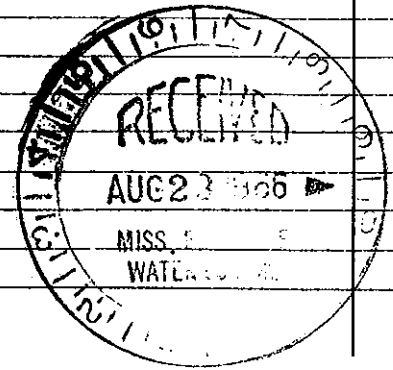

Retain this copy for your office files.