

Aicorn
K 2006

8-25-66 MISSISSIPPI BOARD OF WATER COMMISSIONERS

WATER WELL DRILLERS LOG

Date: August 25, 1966, Driller: Banks Physical Drilling County: Prentiss
(When well drilled) (Name) (Where well is located)

| (1) Owner of Land: (Name) | Description & Color of Materials Sand, Clay, Red Clay, Shell, etc. | Thick- ness Feet | Depth Feet |
|--|---|------------------------|---------------|
| <u>Billy Wren</u> | <u>Clay</u> | <u>21</u> | |
| <u>North Pisgah</u> (Address) | <u>Blue +</u> | <u>280</u> | |
| (2) Location: <u>13 miles N.W. of</u> <u>Boonville</u> (distance) (direction) (Nearest Town) | <u>Shells</u> | | |
| (3) Topography: <u>↓</u> (Hilly) (Flat) (Level) | <u>Water Sand</u> | | |
| (4) Purpose of Well: <u>↓</u> (Domestic Irrigation Municipal, Industrial, Other) | <u>up to</u> | <u>365</u> | |

Information upon completion of well:

- (1) Diameter 4 inches.
- (2) Total Depth 365 feet.
- (3) Water Level 180 feet below top of ground.
- (4) Cased to 21, Size _____
- (5) Screen: Size _____, Length _____
- (6) Were any formations sealed against pollution?
_____ yes, _____ no.

f YES depth of formation _____


Why Jet Set 210 ft

Drillers Remarks _____

Yield in gpm: _____

Size pump: 2 Horse

Type power: _____

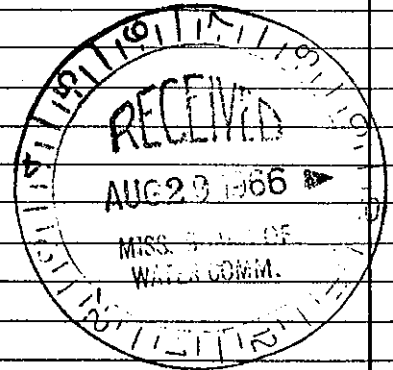

all this copy to Board of Water Commissioners 429 Miss. St. Jackson, Miss.