

Alcorn

MISSISSIPPI BOARD OF WATER COMMISSIONERS

K 2007
11-66

WATER WELL DRILLERS LOG

Date: 11-4, 1966, Driller: Con. F. Fairies County Alcorn
(When well drilled) (Name) (Where well is located)

		Description & Color of Materials Sand, Clay, Red Clay, Shell, etc.	Thick- ness Feet	Depth Feet
(1) Owner of Land: <u>Beecher Mitchell</u> (Name)				
<u>Hay 45 S. Cornith</u> (Address)		<u>Red Clay</u>	<u>21</u>	
		<u>Blue Clay</u>	<u>79</u>	
(2) Location: <u>1/4</u> , <u>1/4</u> , Sec <u>21</u> T <u>3</u> R <u>7E</u>				
<u>8</u> miles <u>S</u> , of <u>Cornith</u> (distance) (direction) (Nearest Town)				
(3) Topography: <input type="checkbox"/> (Hilly) <input type="checkbox"/> (Flat) <input checked="" type="checkbox"/> (Level)				
(4) Purpose of Well: <input checked="" type="checkbox"/> (Domestic) Irrigation Municipal, Industrial, Other				

Information upon completion of well:

- (1) Diameter 5 inches.
- (2) Total Depth 100 feet.
- (3) Water Level _____ feet below top of ground.
- (4) Cased to 21', Size 5"
- (5) Screen: Size None, Length _____
- (6) Were any formations sealed against pollution?
_____ yes, no.

If YES depth of formation _____

Why _____

Drillers Remarks: _____


Yield in gpm: _____

Size pump: no pump

Type power: _____

JUN 20 1968

MISS. BD. OF
WATER COMM.

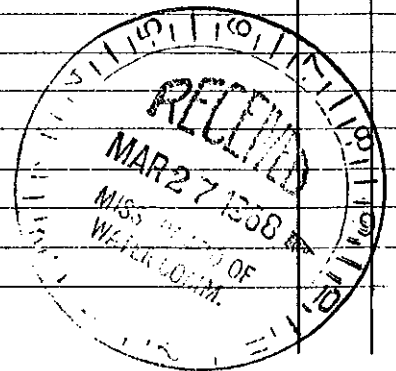

Retain this copy for your office files.