

ALCORN
K 2012

MISSISSIPPI DEPARTMENT OF NATURAL RESOURCES
Bureau of Land and Water Resources
Southport Mall
P.O. Box 10631
Jackson, Mississippi 39209
WATER WELL DRILLERS LOG

03/28 1986 Wilson Well Co Inc Alcorn
date well completed firm name county well located

LANDOWNER	description of formations encountered	from	to
Opeta Palmer Rt 1	Red clay - Blue clay	0	15
Rienzi Mo. 38865 (mailing address)	White sand	15	30
	White sand	30	45
	White sand	45	60
	White sand - Blue clay	60	75

WELL LOCATION:
sec. 36 T 3 N R 7 E
1/2 miles NE of RIENZI
(distance) (direction) (nearest town)

WELL PURPOSE: Home
(home, irrigation, municipal, industrial)

WELL COMPLETION DATA:

(1) diameter (inches) 4"

(2) total depth (feet) 75

(3) static water level (feet) _____ below above top of ground.

(4) casing PVC 55' (material) (depth)
4" (size) If telescope see back.


(5) screen 20' (length) (depth to top)
4" PVC (size) (material)

(6) pump _____ (HP) (yield gpm)
(type power)

(7) electric log (yes or no)
(organization running log)

(8) how well bottom plugged 4" PVC Cap

DRILLERS REMARKS:

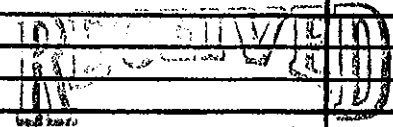

SEP 03 1986

Department of Natural Resources
Bureau of Land & Water Resources