

MISSISSIPPI BOARD OF WATER COMMISSIONERS

AMITE

2774

WATER WELL DRILLERS LOG

CODED

A10
9-27-63

Date: 9-27, 1963, Driller: Chester Reeves County Amite
(Name)

(1) Owner of Land: Lene Arnold
(Name)
RFD - Master
(Address)

(2) Location: 1/4, 1/4, Sec. 32 T4R2
1 miles East of Colles
(distance) (direction) (Nearest Town)

(3) Topography: Hilly
(Hilly) (Flat) (Level)

(4) Purpose of Well: Domestic
(Domestic Irrigation
Municipal, Industrial, Other)

Description & Color of Materials Sand, Clay, Red Clay, Shell, etc.	Thick- ness Feet	D
<u>Top Clay</u>	<u>15</u>	<u>15</u>
<u>Red Sand</u>	<u>35</u>	<u>50</u>
<u>Small gravel & sand</u>	<u>120</u>	<u>170</u>
<u>Coarse Sand</u>	<u>10</u>	<u>180</u>

CODED


Information upon completion of well:

- (1) Diameter 2 inches.
- (2) Total Depth 186 feet.
- (3) Water Level 133 feet below top of ground.
- (4) Cased to Bottom, Size 2"
- (5) Screen: Size 1/4, Length 6'
- (6) Were any formations sealed against pollution?
_____ yes, no.

If YES depth of formation _____

Why _____

Drillers Remarks: good well
Bad

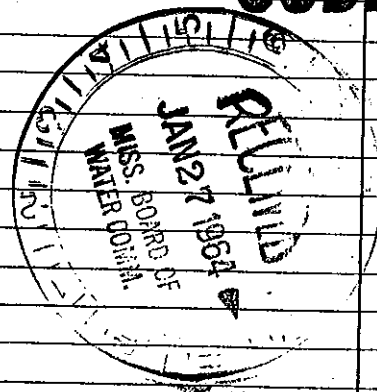

REEVES WELL & PUMP CO.
P. O. BOX 71 - PHONE 884-1451
McCOMB, MISS.

Retain this copy for your office files.

(Use Back Side)

Well No.