

**AMITE** MISSISSIPPI BOARD OF WATER COMMISSIONERS

A-13

**7-16-65 WATER WELL DRILLERS LOG**

CODED

Date: 7-16, 1965, Driller: Chester Lewis County Orwell  
(Name)

(1) Owner of Land:	Description & Color of Materials <small>Sand, Clay, Red Clay, Shell, etc.</small>	Thick- ness Feet	Depth Feet
<u>Eddo Sample</u> <small>(Name)</small> <u>RTD, Gloster</u> <small>(Address)</small>	<u>Red &amp; black top soil</u> <u>base sand</u>	<u>10</u> <u>93</u>	<u>10</u> <u>93</u>
(2) Location: <u>1/4</u> , <u>1/4</u> , Sec. <u>17</u> T <u>4</u> R <u>2</u>			
<u>11</u> miles <u>N1E</u> of <u>Gloster</u> <small>(distance) (direction) (Nearest Town)</small>			
(3) Topography: <u>Flat</u> <small>(Hilly) (Flat) (Level)</small>			
(4) Purpose of Well: <u>Domestic</u> <small>(Domestic Irrigation, Municipal, Industrial, Other)</small>			

Information upon completion of well:

(1) Diameter 4 inches.

(2) Total Depth 93 feet.

(3) Water Level 30 feet below top of ground.

(4) Cased to Bottom size 4"


(5) Screen: Size 4", Length 7'

(6) Were any formations sealed against pollution?  
 \_\_\_\_\_ yes,  no.

If YES depth of formation \_\_\_\_\_

Why \_\_\_\_\_

Drillers Remarks: old well  
had

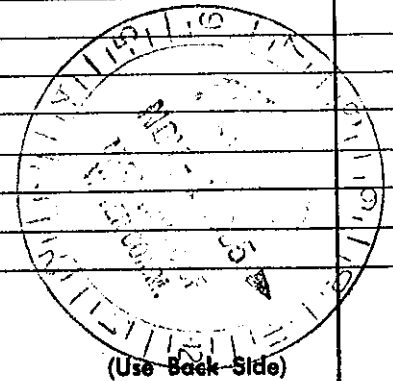

(Use Back Side)

Well No.

Mail this copy to Board of Water Commissioners 429 Miss. St. Jackson, Miss